


TY MAP
0 SCALE

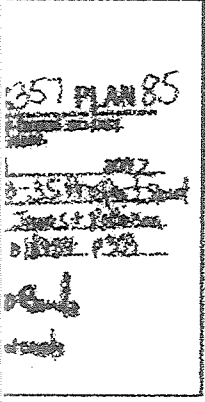

TRY USE


MAP 15
PARCEL 57
N/F
M.B. HALL TR.

I. PIPE FD.
HELD FOR LINE $S53^{\circ}48'44''E$
 $45.67'$ MEAS. ($43'8''$ DEED)

MAP 15
PARCEL 35
N/F
B. BOLICK

I. ROD FD.
HELD

MAP 15
PARCEL 57
N/F
PETER ENGEL

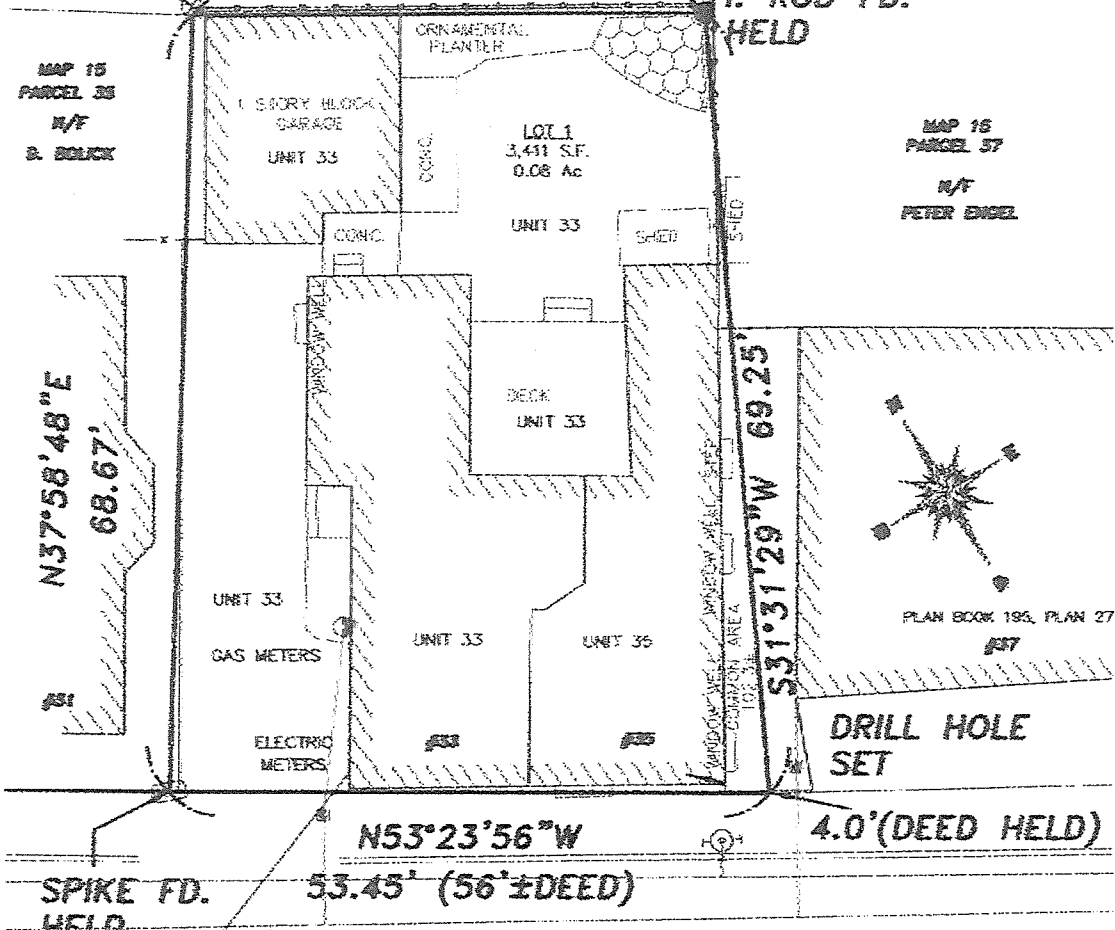

PROSPECT STREET
PUBLIC ~ VARIABLE WIDTH

SITE PLAN

LEGEND

- ⊙ UTILITY POLE
- ⊙ PROPERTY CORNER END
- ⊙ HYDRANT
- ⊙ GAS VALVE
- E --- ELECTRIC LINE
- W --- WATER LINE
- G --- GAS LINE
- OVERHEAD WIRE
- ⊙ POST & RAIL FENCE
- ⊙ STOCKADE FENCE
- ⊙ CHAIN LINK FENCE
- EDGE OF PAVEMENT
- N/F 80% OR FORMERLY

IONS AND AREAS SHOWN AND DEPICTED HEREON ARE APPROXIMATE.

PLAN CONFORMS TO THE RULES AND REGULATIONS
OF DEEDS AND THAT THE PROPERTY LINES SHOWN ON THIS PLAN
ARE EXISTING OWNERSHIP, AND THE LINES OF
STREETS SHOWN ARE THOSE OF PUBLIC OR PRIVATE STREETS
ESTABLISHED, AND THAT NO NEW LINES FOR DIVISION OF
LAND OR FOR NEW WAYS ARE SHOWN.

THIS PLAN FULLY AND ACCURATELY DEPICTS
THE UNIT NUMBER AND DIMENSIONS OF THE UNITS AS BUILT.

UNIT AREA	
BASEMENT	542.4
FIRST FLOOR	717.1
2ND FLOOR	612.9
ATTIC	787.2